

**UNION COUNTY  
SURVEYOR**


Date Received \_\_\_\_\_

Date Filed 5-4-86

By \_\_\_\_\_

File No. #174

SEE NARRATIVE DRAWER  
1/6

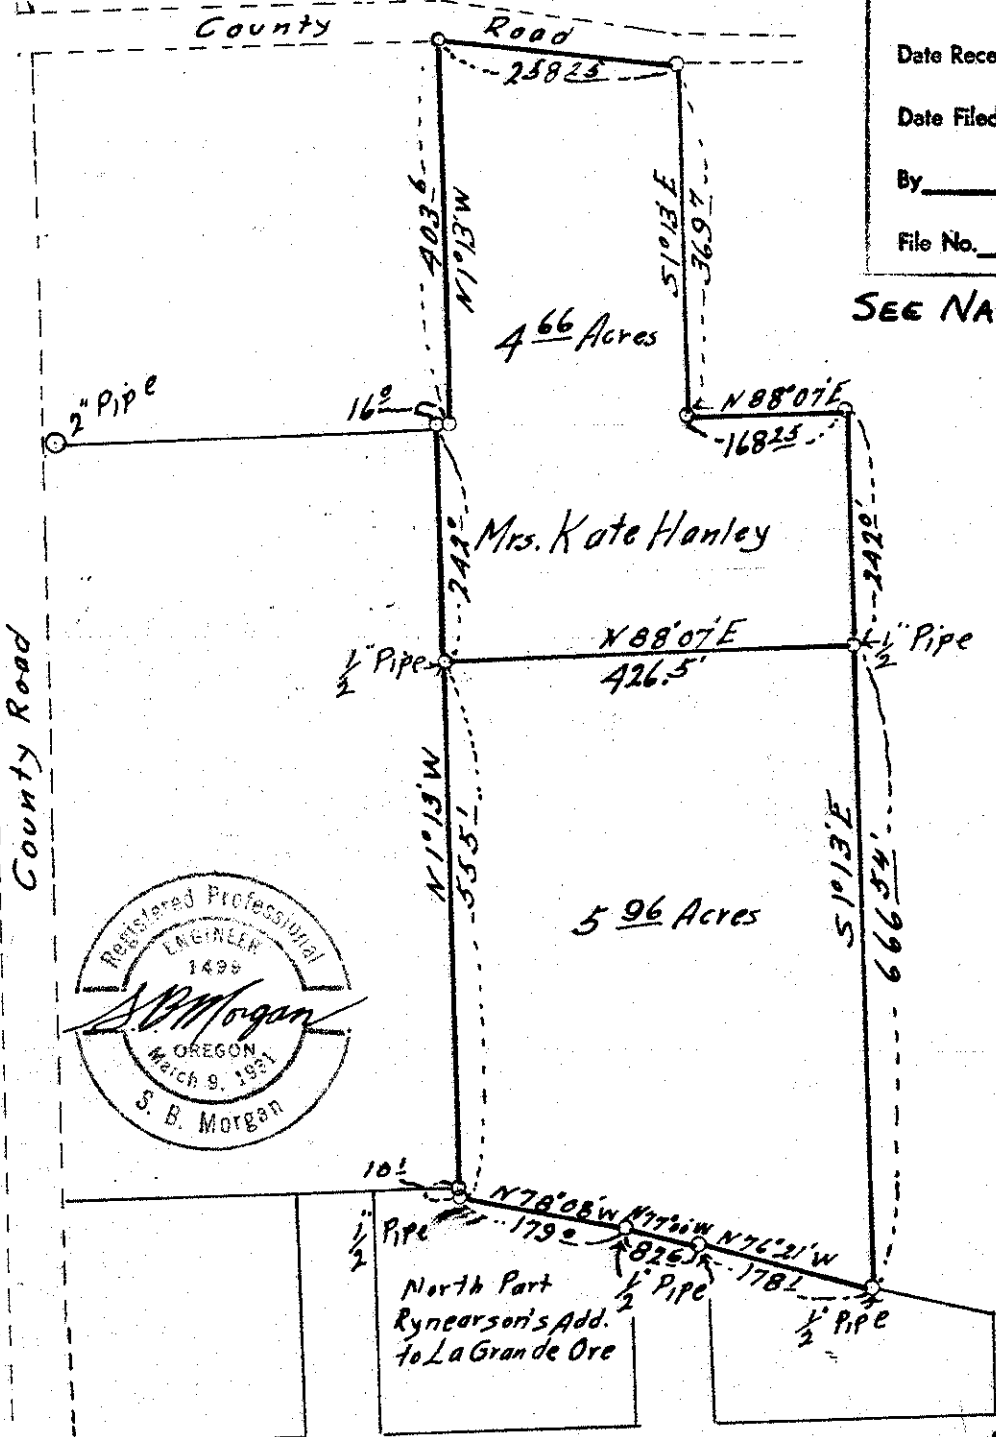

North Part  
Rynearson's Add.  
to La Grande Ore

Scale 1 in = 20 ft.  
Revised Dec. 29, 1947  
Note: Section line not  
to scale

T25R38EWM  
T35R38EWM  
6 31 32  
5