UNION COUNTY SURVEYOR

Date Received _____

Date Filed 3-4-86

By _____

File No. # 176

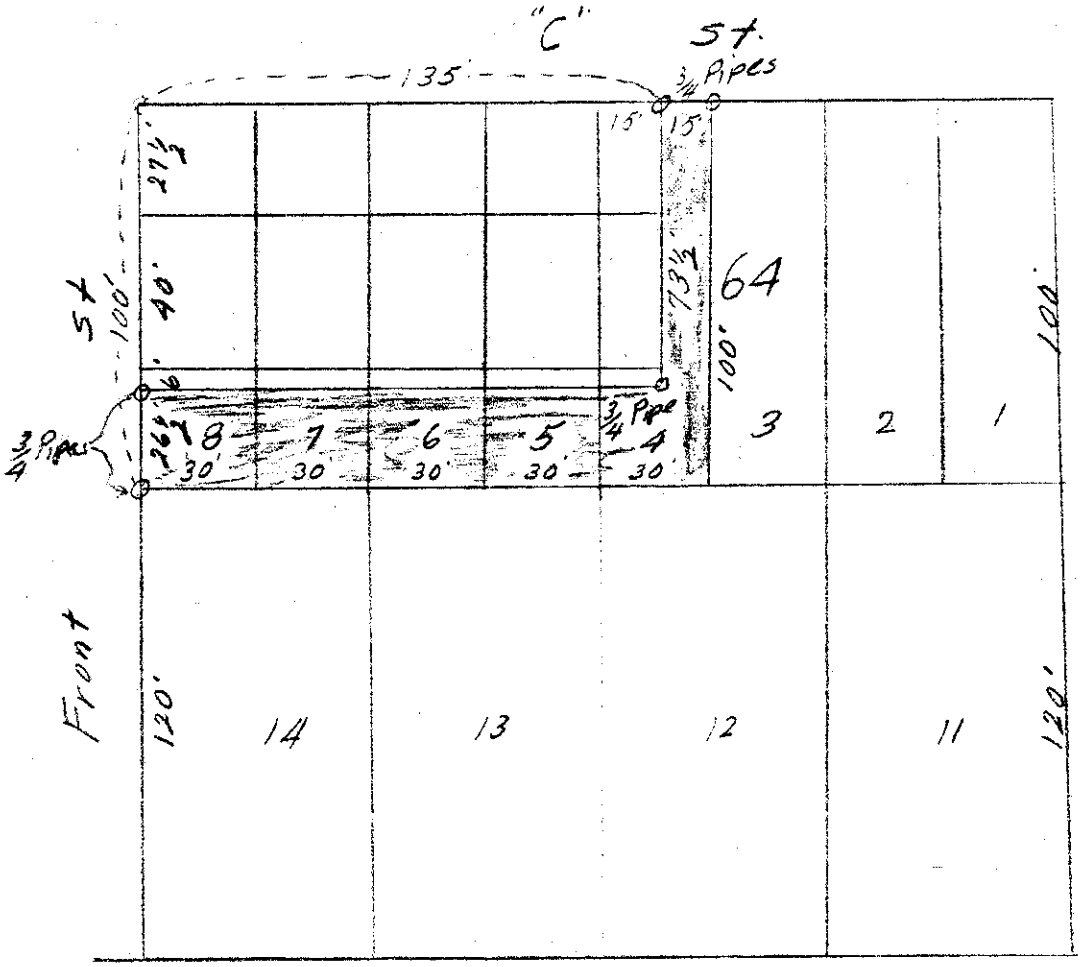

Registered Professional ENGINEER 1499 OREGON March 9, 1962 S. B. Morgan

Block 64
Hindman's Addition to Elgin
Union County, Ore.
Part of Lots. 4, 5, 6, 7 & 8
May 30, 1948 Scale 1 in. = 50 ft