

**UNION COUNTY SURVEYOR**

Date Received \_\_\_\_\_

Date Filed 3-4-86

By \_\_\_\_\_

File No. # 177

Fifth St


440'

1/4" 5g Red Found

80'

St. 400'

35

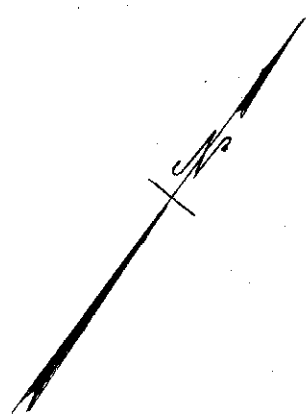


Fourth St

1/4" Round Red Found

on sidewalk

Beginning Point

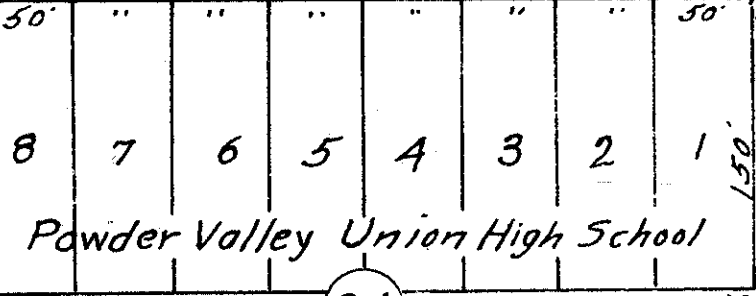


34

400'

2 2/5 Acres

Powder Valley Union High School

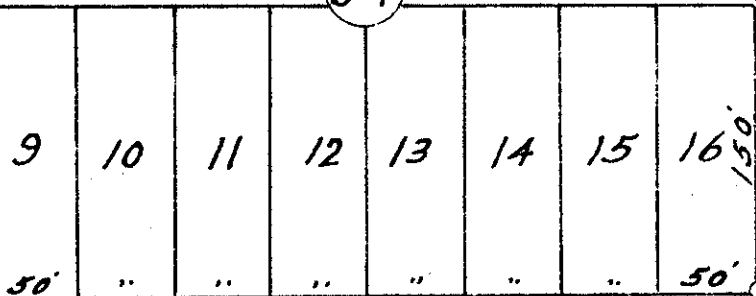

Third St

440'

5/8" Round Red Found

400'

536°45'E

N 36°45' W  
320'

245°  
S 53°15' W

3/4" Pipe

3/4" Pipe

3/4" Pipe

80'

80'

50'

50'

50'

50'




























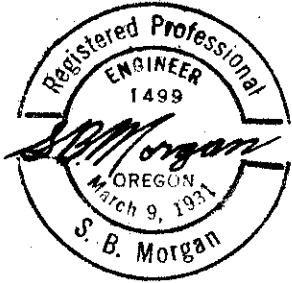

MAP OF  
Powder Valley Union High School Property  
in the City of North Powder Union County  
Oregon 6 2 2/5 Acres West of Block 34 in the  
NE 1/4 of the SW 1/4 of Section 22 T 6 S R 39 E W.M.  
Scale 1 in. = 100 ft. June 5, 1948